
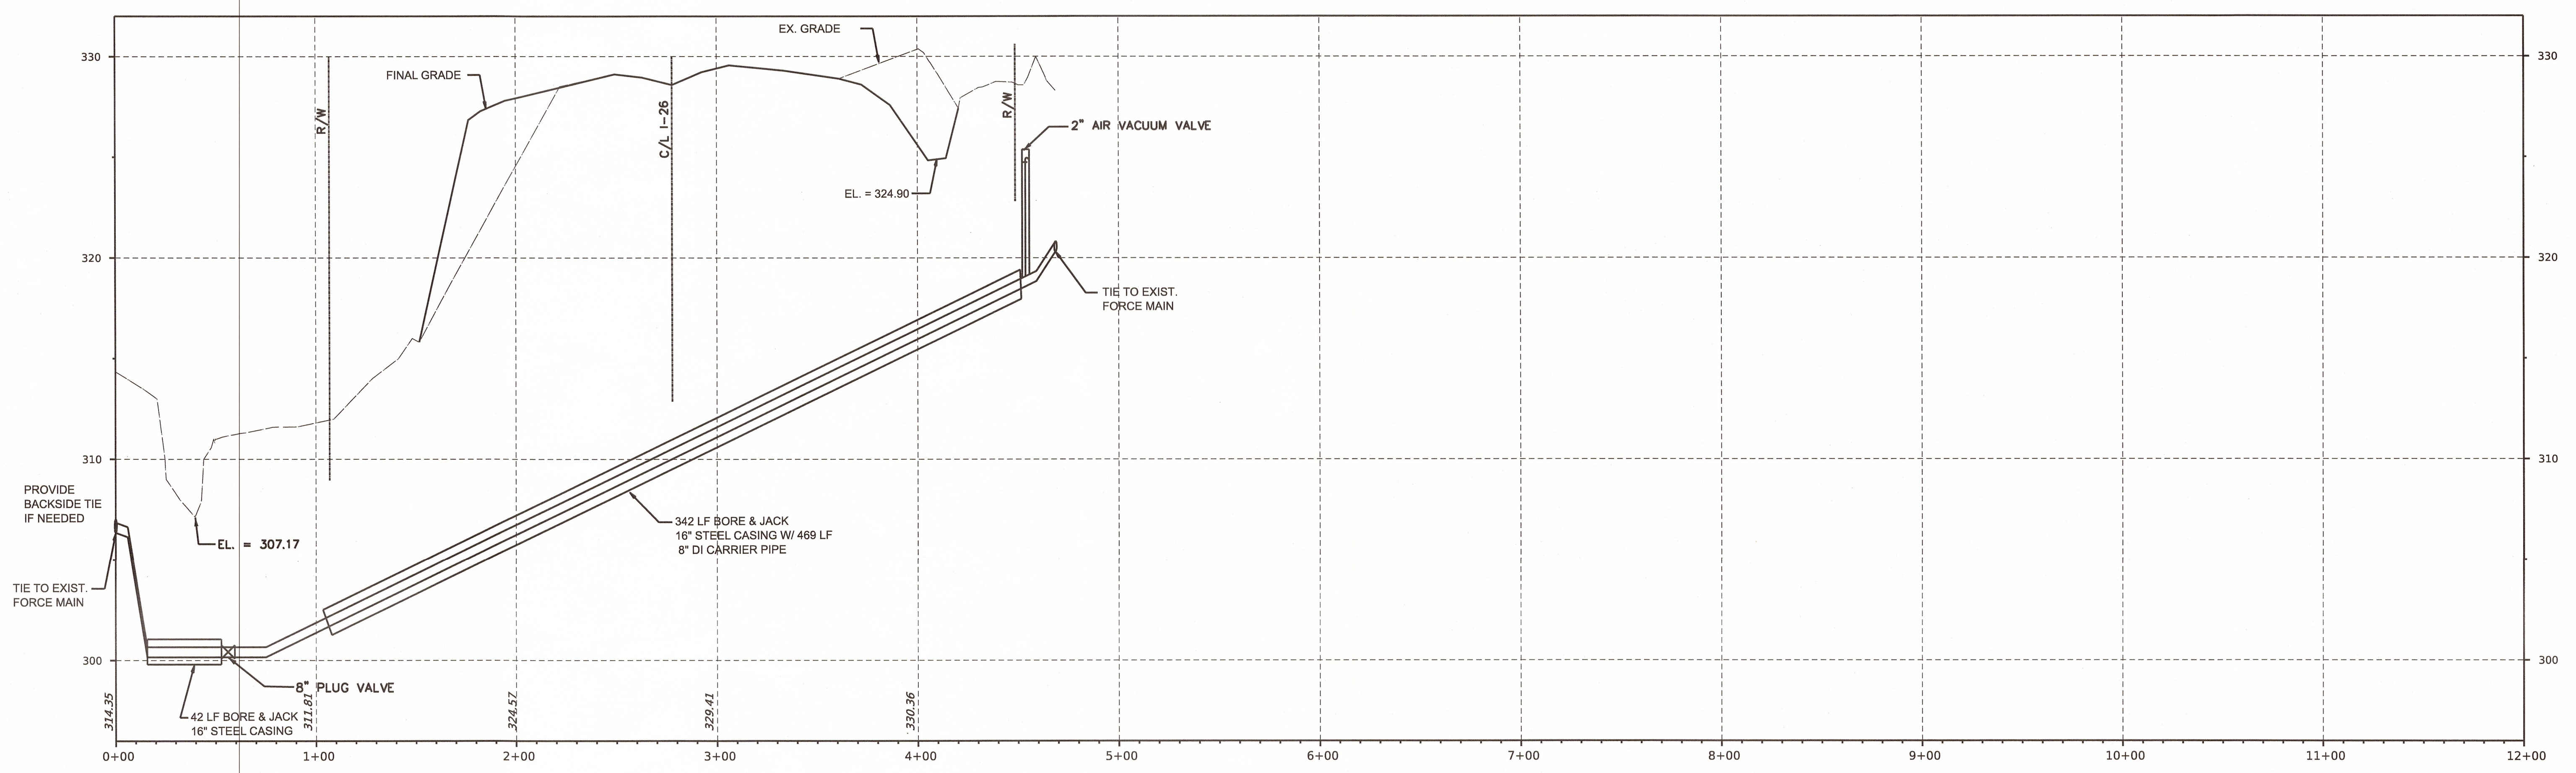
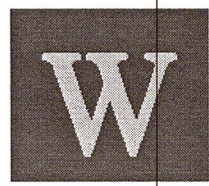


NOTES:  
 1. MARKUP LOCATIONS OF INSTALLED UTILITIES PROVIDED BY CONTRACTOR.  
 2. PROFILE INFORMATION HAS NOT BEEN FIELD VERIFIED AND IS SHOWN FOR INFORMATION ONLY.

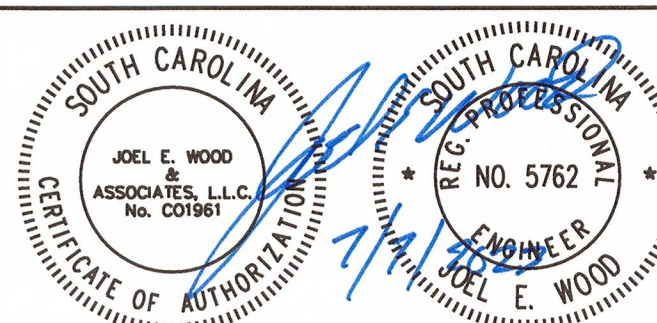

<b>APPROVALS</b> Project Engr: _____ Drawn By: _____ Checked By: _____ Review: _____ Bid: _____ Construction: _____		<b>PREPARED BY</b>  <b>JOEL E. WOOD &amp; ASSOCIATES</b> PLANNING • ENGINEERING • MANAGEMENT P.O. BOX 296 CLOVER, SC 29710 (803) 684-3390		<b>SEALS</b> 		<b>PROJECT</b> SC DOT PROJECT ID# PO 29808 I-26 WIDENING/REHABILITATION - CONFLICT 4 RICHLAND COUNTY, SOUTH CAROLINA PREPARED FOR <b>SCDOT</b>		<b>SHEET TITLE</b> <b>RECORD DRAWING</b> <b>I-26 STATION 805+50</b> <b>FORCE MAIN RELOCATION</b>		<table border="1"> <thead> <tr> <th>NO.</th> <th>DATE</th> <th>REVISIONS</th> <th>BY</th> </tr> </thead> <tbody> <tr> <td>1</td> <td>6/5/20</td> <td>SCDOT COMMENTS</td> <td>CEW</td> </tr> <tr> <td>2</td> <td>8/19/20</td> <td>SCDOT COMMENTS</td> <td>CEW</td> </tr> <tr> <td>3</td> <td>9/24/20</td> <td>SCDOT COMMENTS</td> <td>CEW</td> </tr> <tr> <td>4</td> <td>6/14/23</td> <td>AS BUILT BY CONTRACTOR</td> <td>DER</td> </tr> </tbody> </table>		NO.	DATE	REVISIONS	BY	1	6/5/20	SCDOT COMMENTS	CEW	2	8/19/20	SCDOT COMMENTS	CEW	3	9/24/20	SCDOT COMMENTS	CEW	4	6/14/23	AS BUILT BY CONTRACTOR	DER	SCALE: HORZ : 1" = 40' VERT - 1" = 4' DATE: APRIL 29, 2020 JOB NO.: 190104.3 SHEET 1 OF 1	
NO.	DATE	REVISIONS	BY																														
1	6/5/20	SCDOT COMMENTS	CEW																														
2	8/19/20	SCDOT COMMENTS	CEW																														
3	9/24/20	SCDOT COMMENTS	CEW																														
4	6/14/23	AS BUILT BY CONTRACTOR	DER																														