

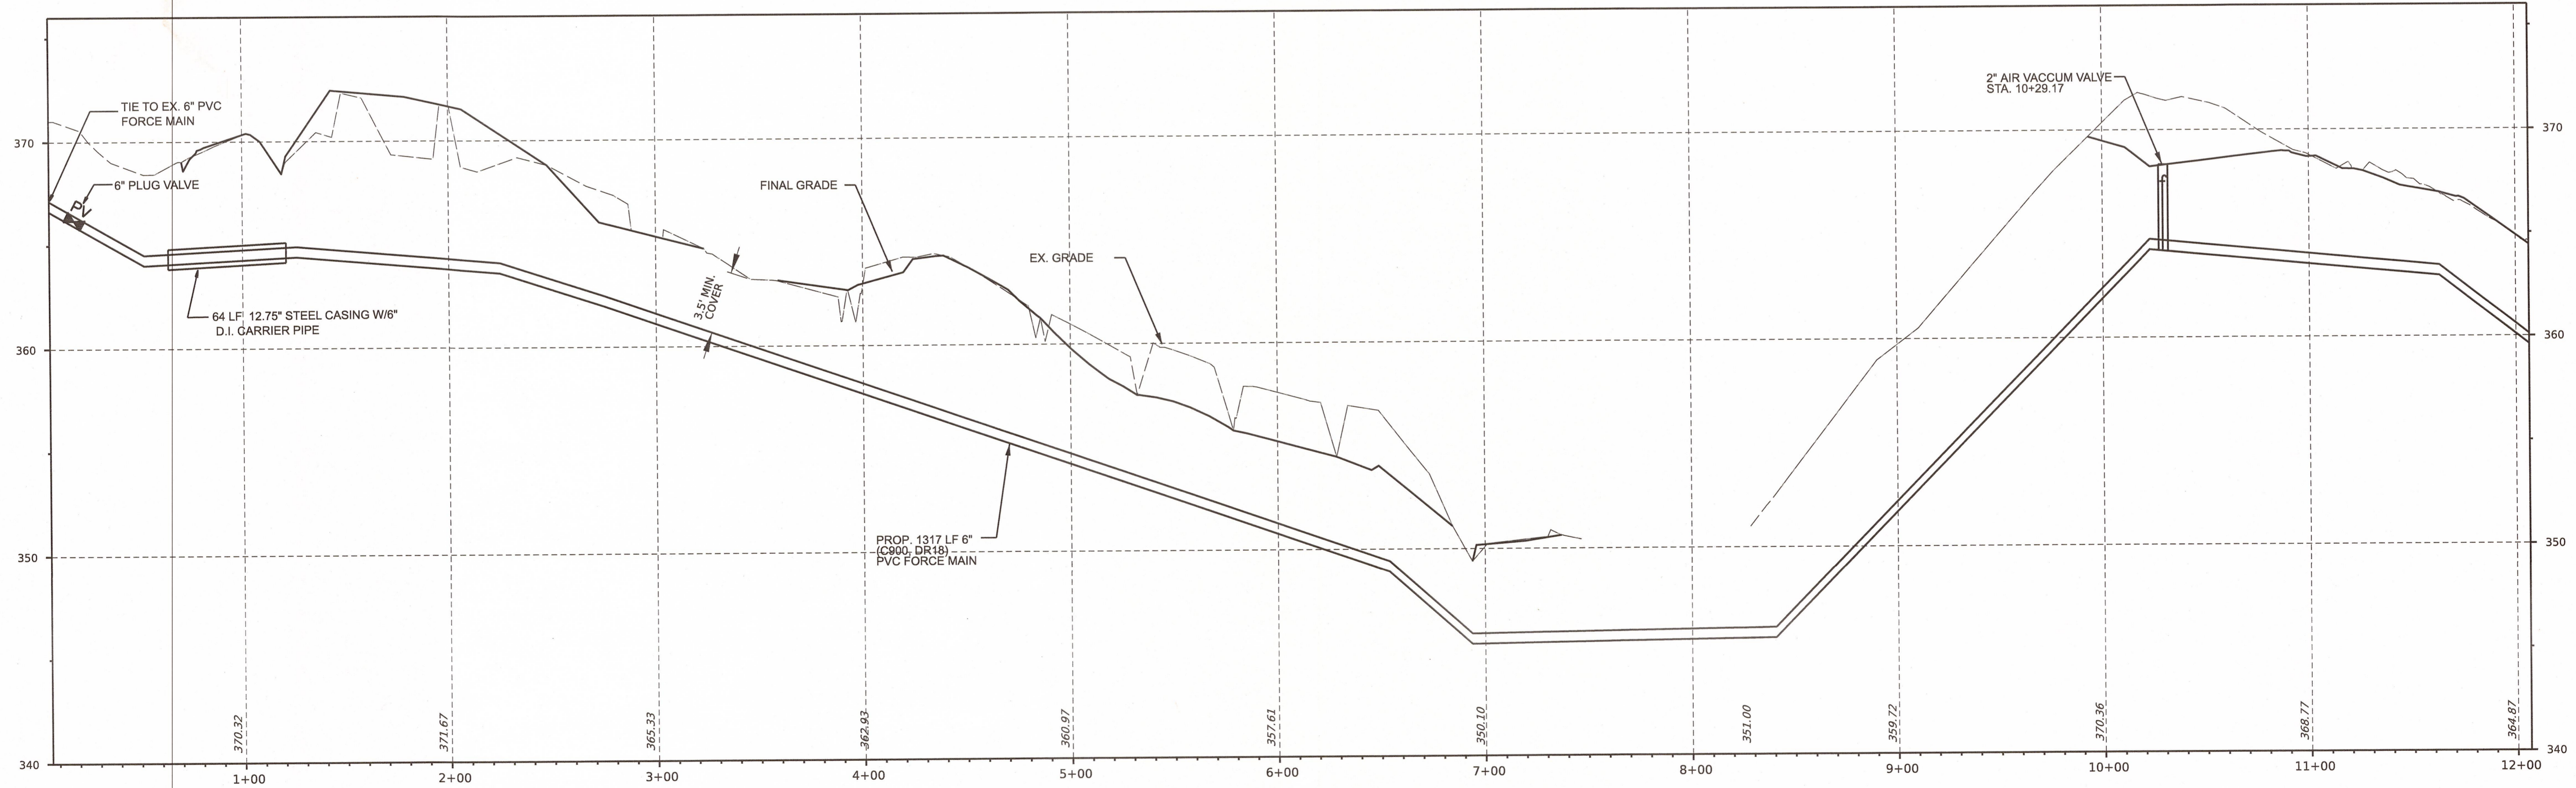
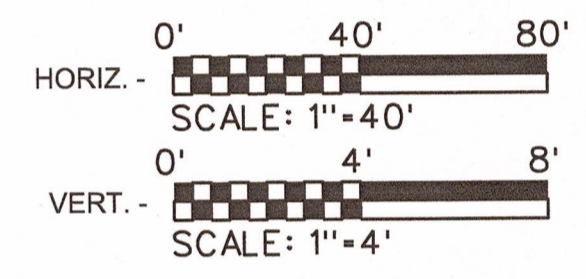


NOTES:  
 1. MARKUPS/LOCATIONS OF INSTALLED UTILITIES PROVIDED BY CONTRACTOR.  
 2. PROFILE INFORMATION HAS NOT BEEN FIELD VERIFIED AND IS SHOWN FOR INFORMATION ONLY.

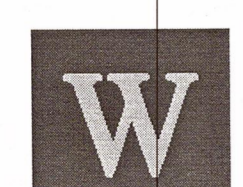


<b>APPROVALS</b> Project Engr: _____ Drawn By: _____ Checked By: _____  Review: _____ Bid: _____ Construction: _____	<b>PREPARED BY</b>  <b>JOEL E. WOOD &amp; ASSOCIATES</b> PLANNING • ENGINEERING • MANAGEMENT P.O. BOX 296 CLOVER, SC 29710 (803) 684-3390	<b>SEALS</b> 	<b>PROJECT</b> SC DOT PROJECT ID# PO 29808 I-26 WIDENING/REHABILITATION - CONFLICT 6 RICHLAND COUNTY, SOUTH CAROLINA PREPARED FOR <b>SCDOT</b>	<b>SHEET TITLE</b> RECORD DRAWING PLAN/PROFILE BROAD BERRY ROAD FORCE MAIN	NO. DATE REVISIONS BY 1 6/5/20 SCDOT COMMENTS CEW 2 8/19/20 SCDOT COMMENTS CEW 3 9/24/20 SCDOT COMMENTS CEW 4 6/14/23 AS BUILT PER CONTRACTOR DER	SCALE: V: 1" = 4', H: 1" = 40' DATE: APRIL 29, 2020 JOB NO.: 190104.3 SHEET 1 OF 2

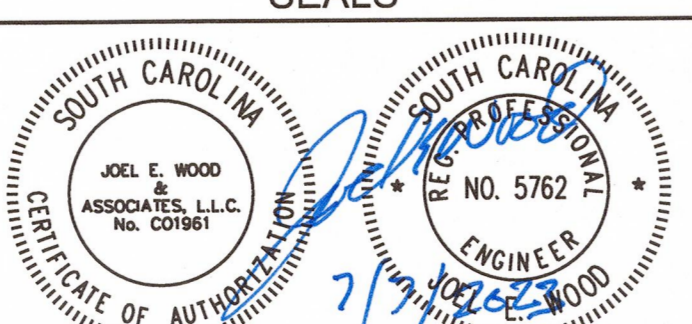

MATCHLINE SHEET 3

STA. 12+00

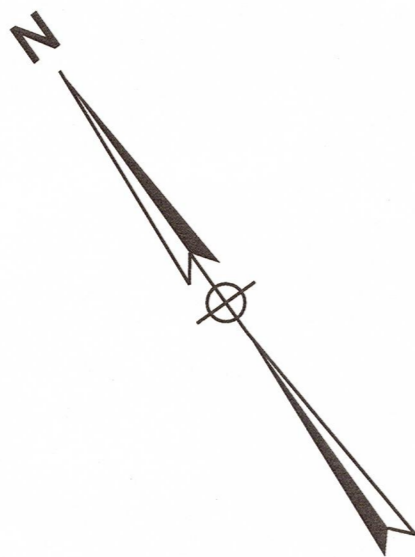

- NOTES:
1. MARKUPS/LOCATIONS OF INSTALLED UTILITIES PROVIDED BY CONTRACTOR.
  2. PROFILE INFORMATION HAS NOT BEEN FIELD VERIFIED AND IS SHOWN FOR INFORMATION ONLY.



PLUG VALVE  
E:1929152.73  
N:841046.16

EX. 6" PVC FORCE MAIN  
ABANDONED IN PLACE

GATE VALVE  
E:1929175.22  
N:841031.84

RAMP A

PRES. RM

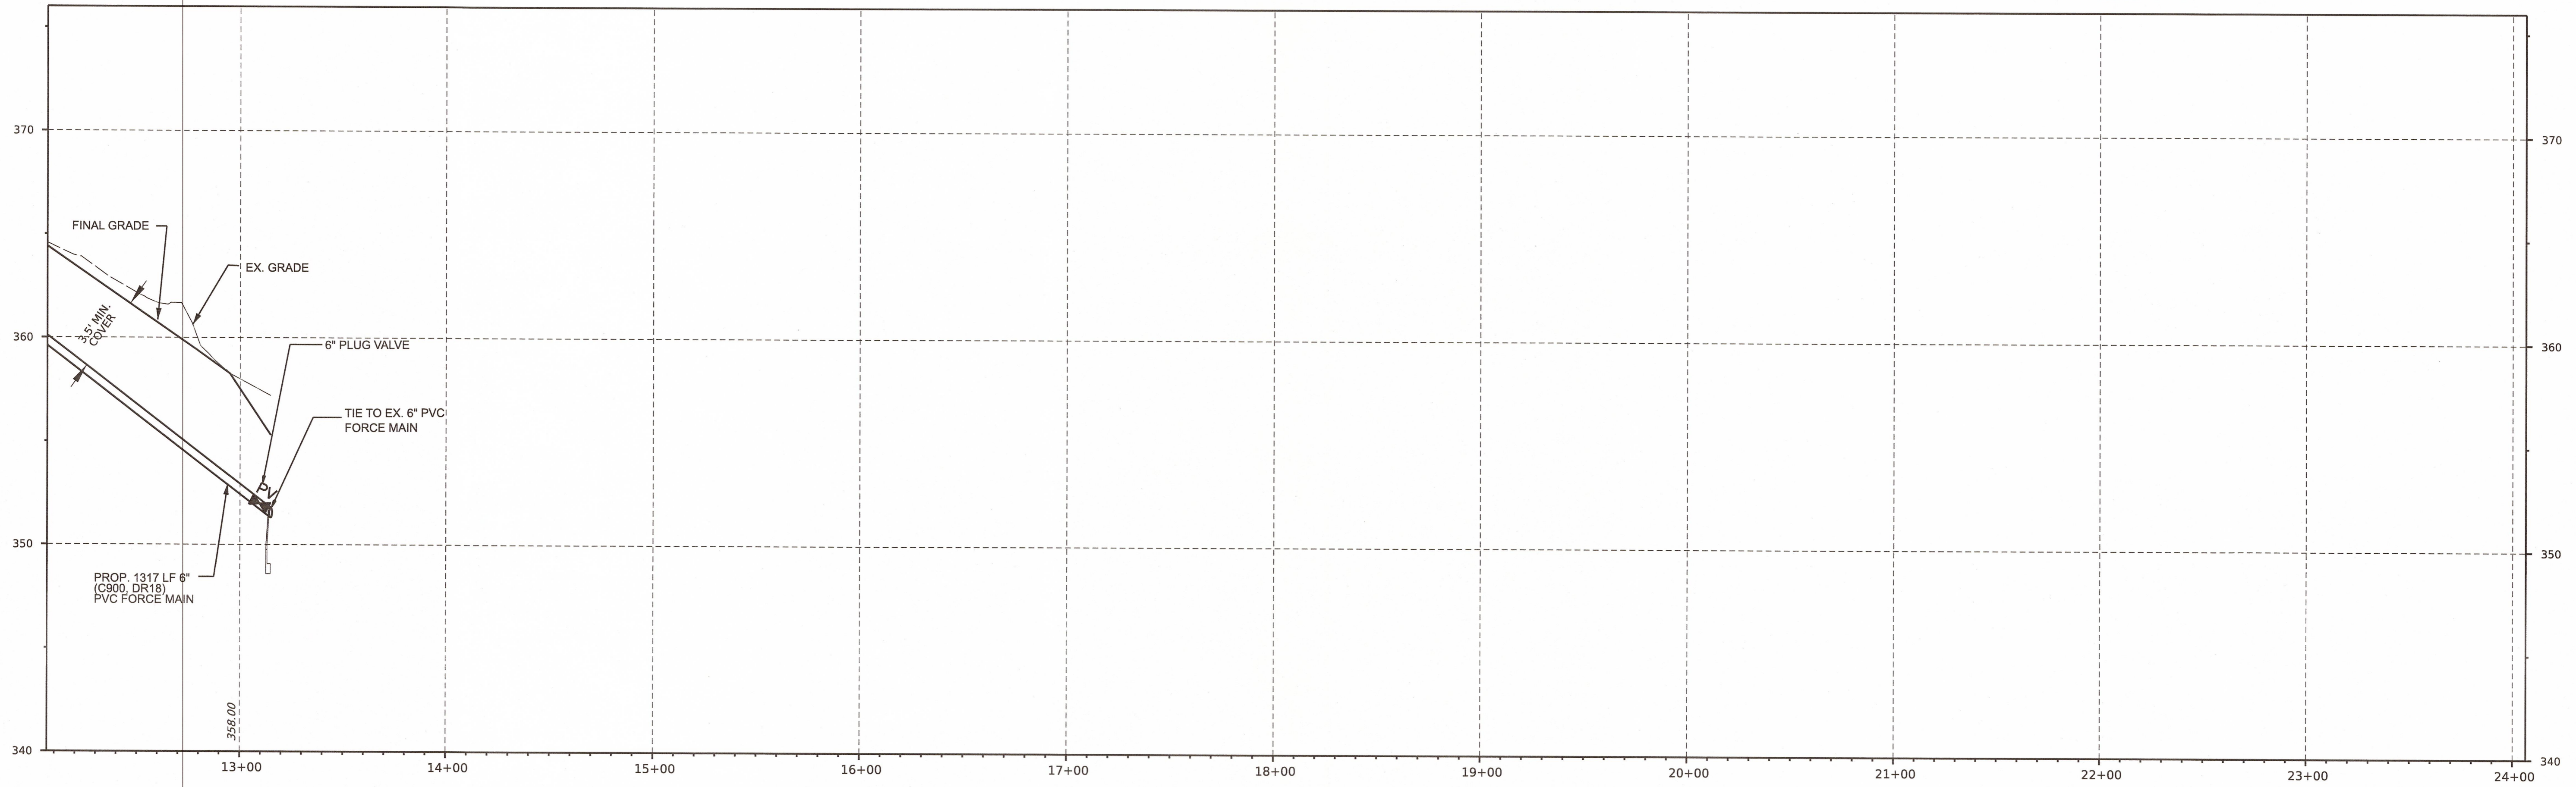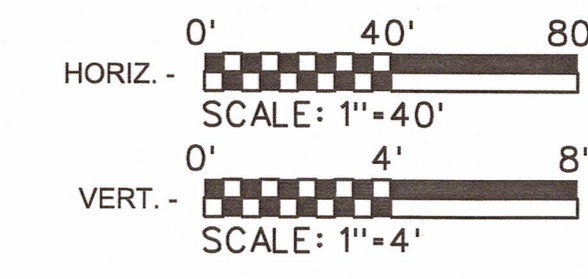

APPROVALS

Project Engr: \_\_\_\_\_  
 Drawn By: \_\_\_\_\_  
 Checked By: \_\_\_\_\_  
 Review: \_\_\_\_\_  
 Bid: \_\_\_\_\_  
 Construction: \_\_\_\_\_

PREPARED BY

**JOEL E. WOOD & ASSOCIATES**  
 PLANNING • ENGINEERING • MANAGEMENT  
 P.O. BOX 296 CLOVER, SC 29710 (803) 684-3390

SEALS

PROJECT

SC DOT PROJECT ID# PO 29808  
 I-26 WIDENING/REHABILITATION - CONFLICT 6  
 RICHLAND COUNTY, SOUTH CAROLINA  
 PREPARED FOR  
**SCDOT**

SHEET TITLE

RECORD DRAWING  
 PLAN/PROFILE BROAD BERRY ROAD  
 FORCE MAIN

NO.	DATE	REVISIONS	BY
1	6/5/20	SCDOT COMMENTS	CEW
2	8/19/20	SCDOT COMMENTS	CEW
3	9/24/20	SCDOT COMMENTS	CEW
4	6/14/23	AS BUILT PER CONTRACTOR	DER

SCALE: V: 1" = 4', H: 1" = 40'  
 DATE: APRIL 29, 2020  
 JOB NO.: 190104.3  
 SHEET 2 OF 2