
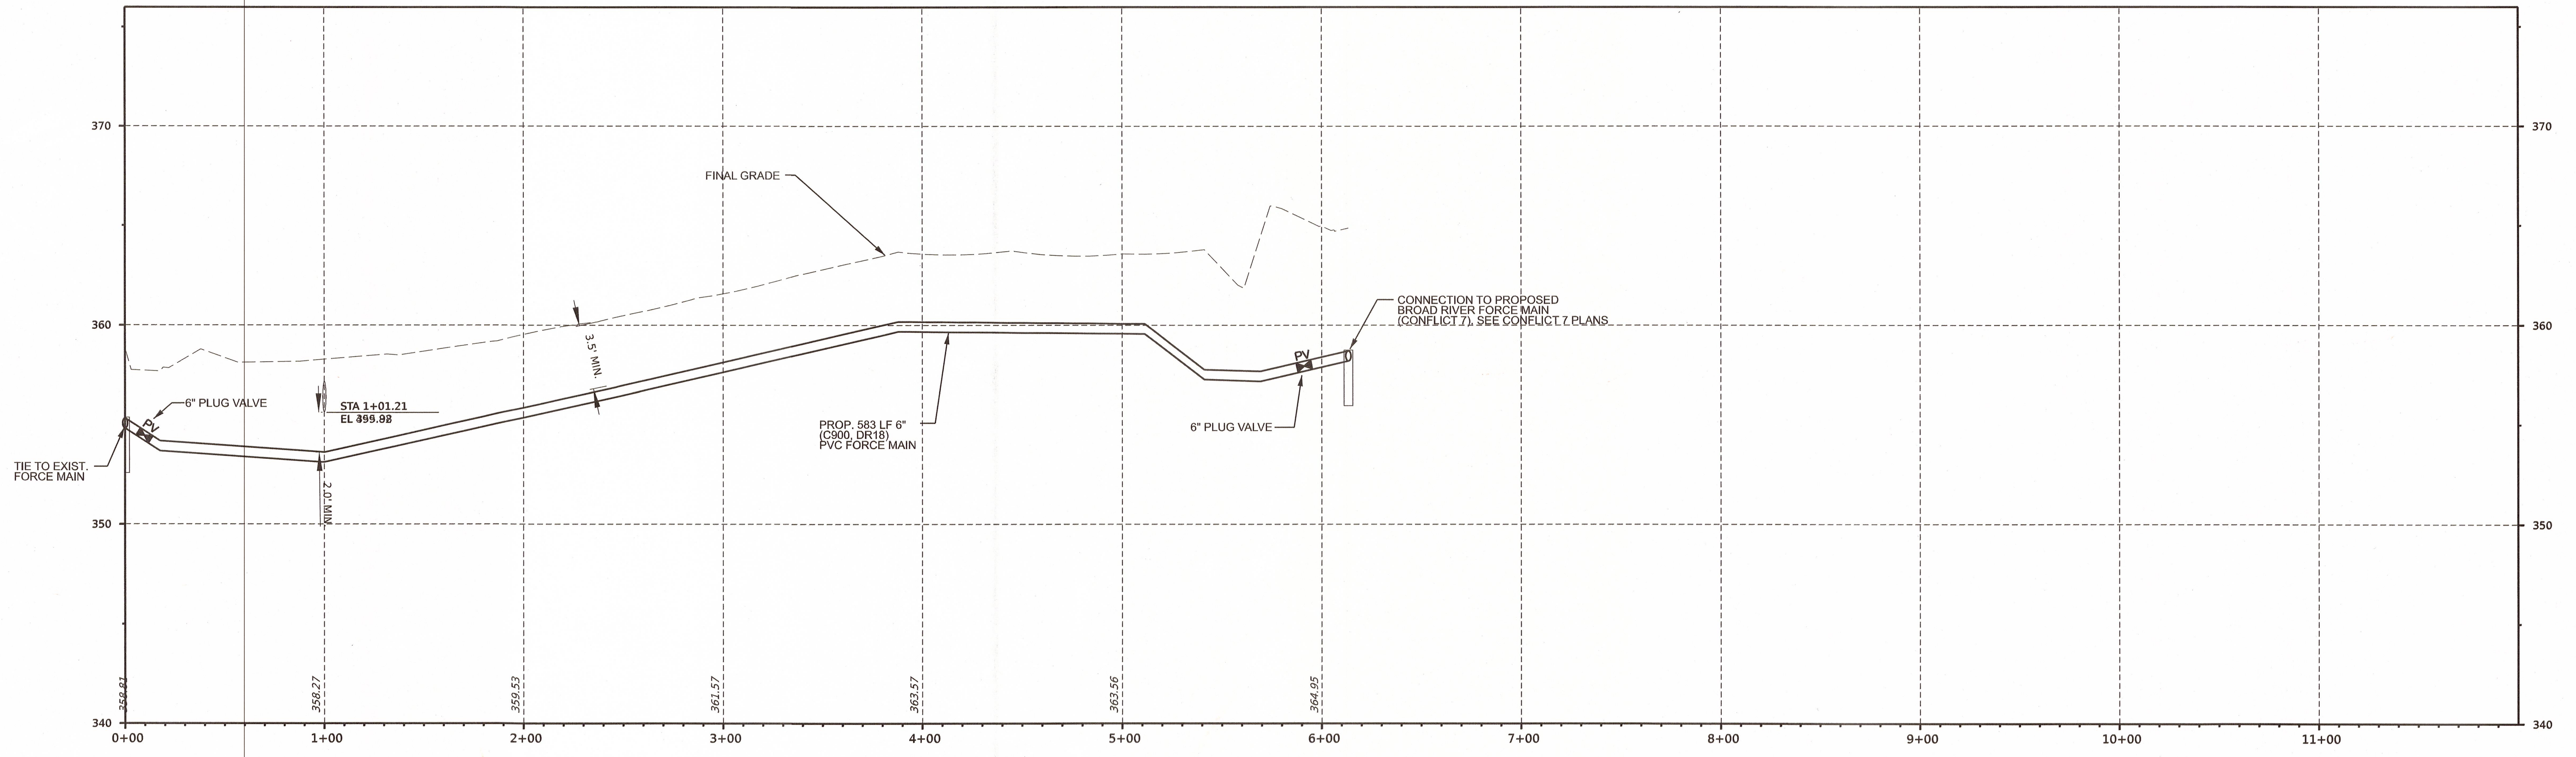


NOTES:
 1. MARKUPS/LOCATIONS OF INSTALLED UTILITIES PROVIDED BY CONTRACTOR.
 2. PROFILE INFORMATION HAS NOT BEEN FIELD VERIFIED AND IS SHOWN FOR INFORMATION ONLY.

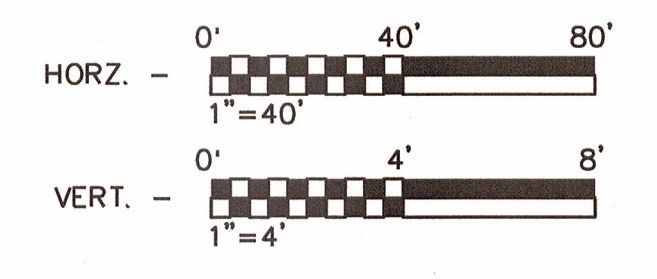

APPROVALS Project Engr: _____ Drawn By: _____ Checked By: _____ Review: _____ Bid: _____ Construction: _____	PREPARED BY <div style="text-align: center;"> JOEL E. WOOD & ASSOCIATES PLANNING • ENGINEERING • MANAGEMENT P.O. BOX 296 CLOVER, SC 29710 (803) 684-3390 </div>	SEALS <div style="text-align: center;"> </div>	PROJECT SC DOT PROJECT ID# PO 29808 I-26 WIDENING/REHABILITATION - CONFLICT 8 RICHLAND COUNTY, SOUTH CAROLINA PREPARED FOR SCDOT	SHEET TITLE RECORD DRAWING PLAN/PROFILE SHADY GROVE ROAD FORCE MAIN	<table border="1" style="width:100%; border-collapse: collapse;"> <thead> <tr> <th>NO.</th> <th>DATE</th> <th>REVISIONS</th> <th>BY</th> </tr> </thead> <tbody> <tr> <td>1</td> <td>6/5/20</td> <td>SCDOT COMMENTS</td> <td>CEW</td> </tr> <tr> <td>2</td> <td>8/19/20</td> <td>SCDOT COMMENTS</td> <td>CEW</td> </tr> <tr> <td>3</td> <td>9/21/20</td> <td>SCDOT COMMENTS</td> <td>CEW</td> </tr> <tr> <td>4</td> <td>12/15/20</td> <td>ROADWAY DESIGN CHANGES</td> <td>CEW</td> </tr> <tr> <td>5</td> <td>6/29/23</td> <td>AS BUILT BY CONTRACTOR</td> <td>DER</td> </tr> </tbody> </table>	NO.	DATE	REVISIONS	BY	1	6/5/20	SCDOT COMMENTS	CEW	2	8/19/20	SCDOT COMMENTS	CEW	3	9/21/20	SCDOT COMMENTS	CEW	4	12/15/20	ROADWAY DESIGN CHANGES	CEW	5	6/29/23	AS BUILT BY CONTRACTOR	DER
NO.	DATE	REVISIONS	BY																										
1	6/5/20	SCDOT COMMENTS	CEW																										
2	8/19/20	SCDOT COMMENTS	CEW																										
3	9/21/20	SCDOT COMMENTS	CEW																										
4	12/15/20	ROADWAY DESIGN CHANGES	CEW																										
5	6/29/23	AS BUILT BY CONTRACTOR	DER																										
					SCALE: HORZ : 1" = 40' VERT : 1" = 4' DATE: APRIL 29, 2020 JOB NO.: 190104.3 SHEET 1 OF 1																								