
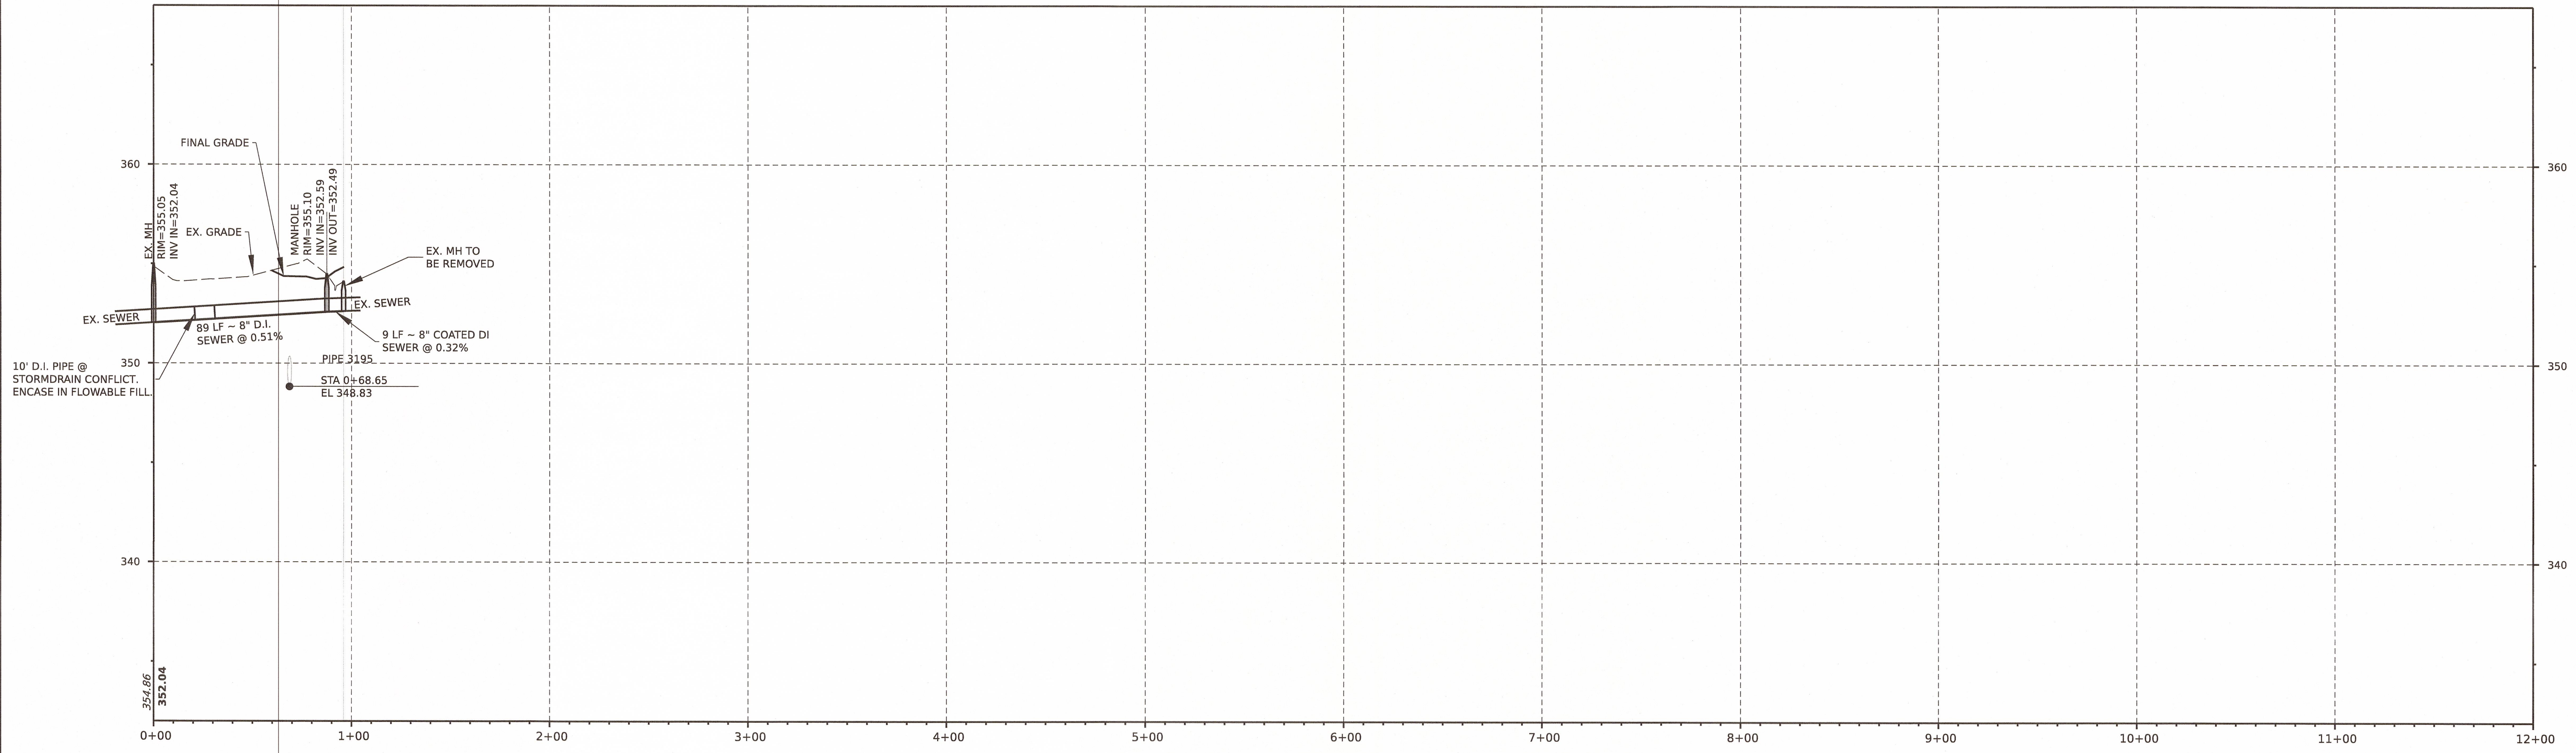


NOTES:  
 1. MARKUPS/LOCATIONS OF INSTALLED UTILITIES PROVIDED BY CONTRACTOR.  
 2. PROFILE INFORMATION HAS NOT BEEN FIELD VERIFIED AND IS SHOWN FOR INFORMATION ONLY.

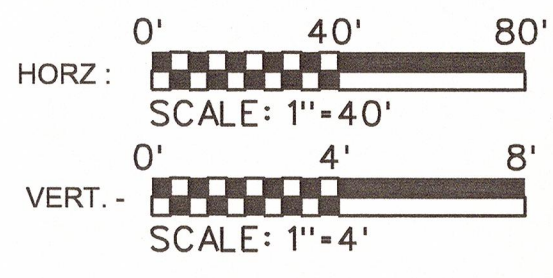

APPROVALS	
Project Engr:	_____
Drawn By:	_____
Checked By:	_____
Review:	_____
Bid:	_____
Construction:	_____

PREPARED BY

**JOEL E. WOOD & ASSOCIATES**  
 PLANNING • ENGINEERING • MANAGEMENT  
 P.O. BOX 296 CLOVER, SC 29710 (803) 684-3390

SEALS

**PROJECT**

SC DOT PROJECT ID# PO 29808  
 I-26 WIDENING/REHABILITATION - CONFLICT 9

RICHLAND COUNTY, SOUTH CAROLINA  
 PREPARED FOR  
**SCDOT**

**SHEET TITLE**

RECORD DRAWING  
 8" GRAVITY SEWER RELOCATION  
 PLAN & PROFILE

NO.	DATE	REVISIONS	BY
1	6/5/20	SCDOT COMMENTS	CEW
2	8/19/20	SCDOT COMMENTS	CEW
3	9/24/20	SCDOT COMMENTS	CEW
4	2/2/21	STORMDRAIN CONFLICT	CEW
5	6/14/23	AS BUILT PER CONTRACTOR	DER

SCALE: V: 1" = 4', H: 1" = 40'

DATE: APRIL 29, 2020

JOB NO.: 190104.3

SHEET 1 OF 1